Thursday, 13/11/2008 9:25:59 AM

User:

Chantal Lavoie

**Process Sheet** 

Customer

: CU-DAR001 Dart Helicopters Services

Job Number

: 43078

**Estimate Number** 

: 10880

P.O. Number

This Issue

: 13/11/2008

: NC

Prsht Rev.

First Issue **Previous Run**  : 11 : 43078 Type

S.O. No. :

: PURCHASED PARTS

**Part Number** 

: D3251041

: CENTER DIVIDER

**Drawing Number** 

**Drawing Name** 

: D3251 REV A

**Project Number Drawing Revision**  : N/A

Material

: A

**Due Date** 

: 20/11/2008

Qtv:

3 Um: Each

Written By Comment

Checked & Approved By

04.10.26 D3251-1 no longer made in-house

08.11.13 in-house

EC verified by: DD

**Additional Product** 

Job Number:



Seq. #:

**Machine Or Operation:** 

Description:

1.0

M2024T3S063

2024-T3 .063 sheet



Comment: Qty.:

3.5805 sf(s)/Unit Total: 10.7415 sf(s)

2024-T3 .063 sheet

batch: 109 463

IR 6-11-13

2.0

WATER JET

FLOW WATER JET



Comment: FLOW WATER JFT

1-Cut as per Dwg D3251

Dwg Rev: A

B8-11-13





2-Deburr if necessary

138-11-13

3.0

INSPECT PARTS AS THEY COME OFF MACHINE



188-11-13

Comment: INSPECT PARTS AS THEY COME OFF MACHINE

4.0

QC8

QC2

SECOND CHECK



Comment: SECOND CHECK

SMALL FAB 1

SMALL & MEDIUM FAB RESOURCE 1







Comment: SMALL & MEDIUM FAB RESOURCE 1

Bend as per dwg D3251

Page 1


Form: rprocess


Date: Thursday, 13/11/2008 9:25:59 AM User:\* Chantal Lavoie **Process Sheet** Customer: CU-DAR001 Dart Helicopters Services **Drawing Name: CENTER DIVIDER** Job Number: 43078 Part Number: D3251041 Job Number: Sea. #: **Machine Or Operation: Description:** 6.0 INSPECT WORK TO CURRENT STEP Comment: INSPECT WORK TO CURRENT STEP 7.0 HAND FINISHING1 HAND FINISHING RESOURCE #1 Comment: HAND FINISHING RESOURCE #1 Chemical Conversion Coat as per QSI 005 4.1 8.0 QC3 INSPECT POWDER COAT/CHEMICAL CONVERSION Comment: INSPECT POWDER COAT/CHEMICAL CONVERSION 9.0 D32481 Comment: Qty.: 2.0000 Each(s)/Unit Total: 6.0000 Each(s) Doubler Pick: Qty Part Number Description Batch B 22636 (4) F 08/02/09 D3248-1 Doubler 10.0 MS20470AD45 Rivet, Universal Head Comment: Qty.: 18.0000 Each(s)/Unit Total: 54.0000 Each(s) Rivet, Universal Head Pick: **Qty Part Number** Description Batch M106918 MS20470AD4-5Rivet Assemble D3251-041 as per Dwg D3251 SMALL FAB 1 SMALL & MEDIUM FAB RESOURCE 1 Comment: SMALL & MEDIUM FAB RESOURCE 1 Assemble as per dwg D3251 12.0 QC5 INSPECT WORK TO CURRENT STEP Comment: INSPECT WORK TO CURRENT STEP

Date: Thursday, 13/11/2008 9:25:59 AM User: Chantal Lavoie **Process Sheet** Customer: CU-DAR001 Dart Helicopters Services **Drawing Name: CENTER DIVIDER** Job Number: 43078 Part Number: D3251041 Job Number: Seq. #: **Machine Or Operation:** Description: 13.0 POWDER COATING POWDER COATING **Comment: POWDER COATING** Powder Coat Black Sandtex (Ref: 4.3.5.7) as per QSI 005 4.3 START TIME: **OVEN TEMPERATURE:** FINISH TIME: 14.0 QC3 INSPECT POWDER COAT/CHEMICAL CONVERSION Comment: INSPECT POWDER COAT/CHEMICAL CONVERSION 15.0 PACKAGING 1 PACKAGING RESOURCE #1 Comment: PACKAGING RESOURCE #1 Identify and Stock Location: 16.0 QC21 Comment: FINAL INSPECTION/W/O RELEASE Job Completion



DESIGN 7#	DRAWN BY		ROSPACE LTD y, ontario, canada
CHECKED	APPROVED	DRAWING NO. D3251	REV. A SHEET 1 OF 1
DATE		TITLE	SCALE
04.04.06		CENTRE DIVIDER (	DUAL BATTERY RACK) 1:6

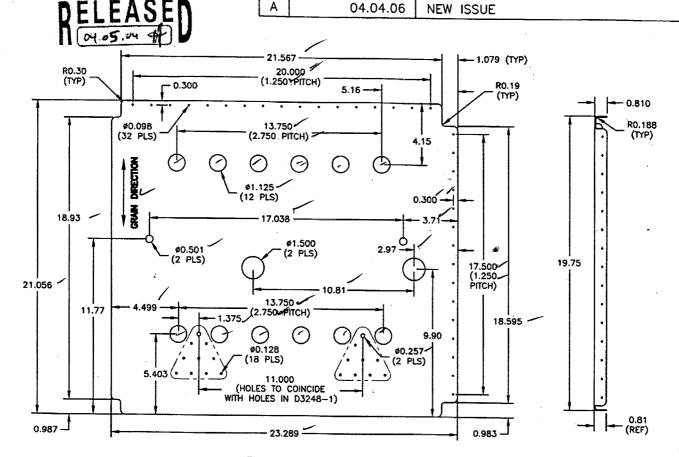

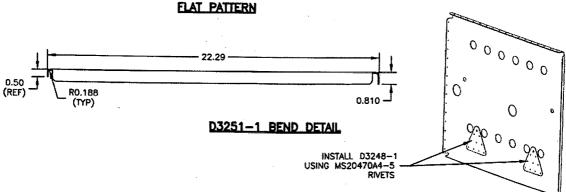

NOTES:

1) MATERIAL: 2024-T3 (QQ-A-250/4) 0.063 THICK (REF. DART SPEC. M2024T3S.063)
2) FINISH: CHEMICAL CONVERSION COAT PER DART QSI 005 4.1
POWDER COAT BLACK SANDTEX (4.3.5.7) PER DART QSI 005 4.3
3) TOLERANCES ARE PER DART QSI 018 UNLESS OTHERWISE NOTED

ALL DIMENSIONS ARE IN INCHES BREAK ALL SHARP EDGES 0.005 TO 0.010

ENGINEER NG D3251 NTROLLED COPY SUBJECT TO AMENDMENT WITHOUT NOTICE

SHOP COPY RETURN TO

Copyright © 2004 by DART AEROSPACE LTD

THIS DOCUMENT IS PRIVATE AND CONFIDENTIAL AND IS SUPPLIED ON THE EXPRESS CONDITION THAT IT IS NOT TO BE USED FOR ANY PURPOSE OR COPIED OR COMMUNICATED TO ANY OTHER PERSON WITHOUT WRITTEN PERMISSION FROM DART AEROSPACE LTD.

DART AEROSPA	CE LTD		Work Order:	43078	
		0.5			
Description:	CENTER	DIVIDER	••	Part Number:	03251-1
Inspection Dwg: D3	29 Rev:	4			Page 1 of 1

## FIRST ARTICLE INSPECTION CHECKLIST

X First Article X Prototype

Drawing Dimension	Tolerance	Actual Dimension	Accept	Rejest	Method of Inspection	Comments
860. Ø	4.004-001	,167	ķ			
861 Q	+ .005 -661	130	¥			
T26, D	+,006-001	257	K		·	
& 1.13S	100-510, +	1.136	×		4.70	
\$ 1.500	100-510. +	1.500	×			
Ø . SOI	100-001	,507	10			
.306	4010	305	*	<i></i>		
20.000	4-010	20.000	>			
21.567	4010	21.567	×			
Silb	+030	5,161	<b>X</b>			
4.15	.030	4.15>	X			
1.679	4/010	1.080	<b>X</b>		·	3
	4 030	3,71	×			
17.038	4- 010	17.038	文	·		
13.750	010	13,756	×			
7.750	7010	2,747	×			
17.500	1/2 .010	17.500	Q			
1.350	1-010	1.748	λ <del>e</del>			ù.
18.595	4010	18.595	×			·
. 983	4010	,985	<i>X</i>			
1.370 13-20	4010	1,375	B			
4.499	400	4.499	×	,		
1.375	4- ,010	1375	X			

Measured by:	LB.	Audited by:	711	Prototype Approval:	1	/
Date:	8-11-13	Date: C	25/4/14	Date:		9
				•	•	

Rev	Date	Change	O.	Revised by Approved
Α		New Issue	1/0 D3251-041	KJ/JLM



DART AEROSP	ACE LTD		Work Order:	43078	
44		4.6			
Description:	CENTER	DIVIDER	*4.	Part Number:	03921-1
			_ \	·	
Inspection Dwg()	7561 . Rev:	<u> </u>		•	Page 1 of 1

## FIRST ARTICLE INSPECTION CHECKLIST

X	First Article	X	Prototype
	i ii ot Artioio	للتنا	, incortibe

Drawing Dimension	Tolerance	Actual Dimension	Accept	Rejest	Method of Inspection	Comments
5,403	1/2 1010	5,404	×			
9.90	4030	9,90	Ø			
10.81	7030	10,799	×			
2.97	+/030	2,97	8		<b>**•</b>	
11.17	1/ 036	11.75	X			• •
.987	1- 610	,987	2	·		
<del> </del>	t/030	18.93	X	<u></u>		
	- 010	21.056	8			
11.000	4 .010	10,995	حا			
			·			
					٠.	ŧ
	•					
					-	<u>.</u>
	:				e ge	
						:
		ė				

Measured by:	18	Audited by:	131	Prototype Approval:	1	
Date:	9-11-13	Date:	08/11/	Date:		A

Rev	Date	Change	-	0		Revised by	Approved
Α		New Issue	f	. 1	0 7 3251-041	KJ/JLM	
				-7			